
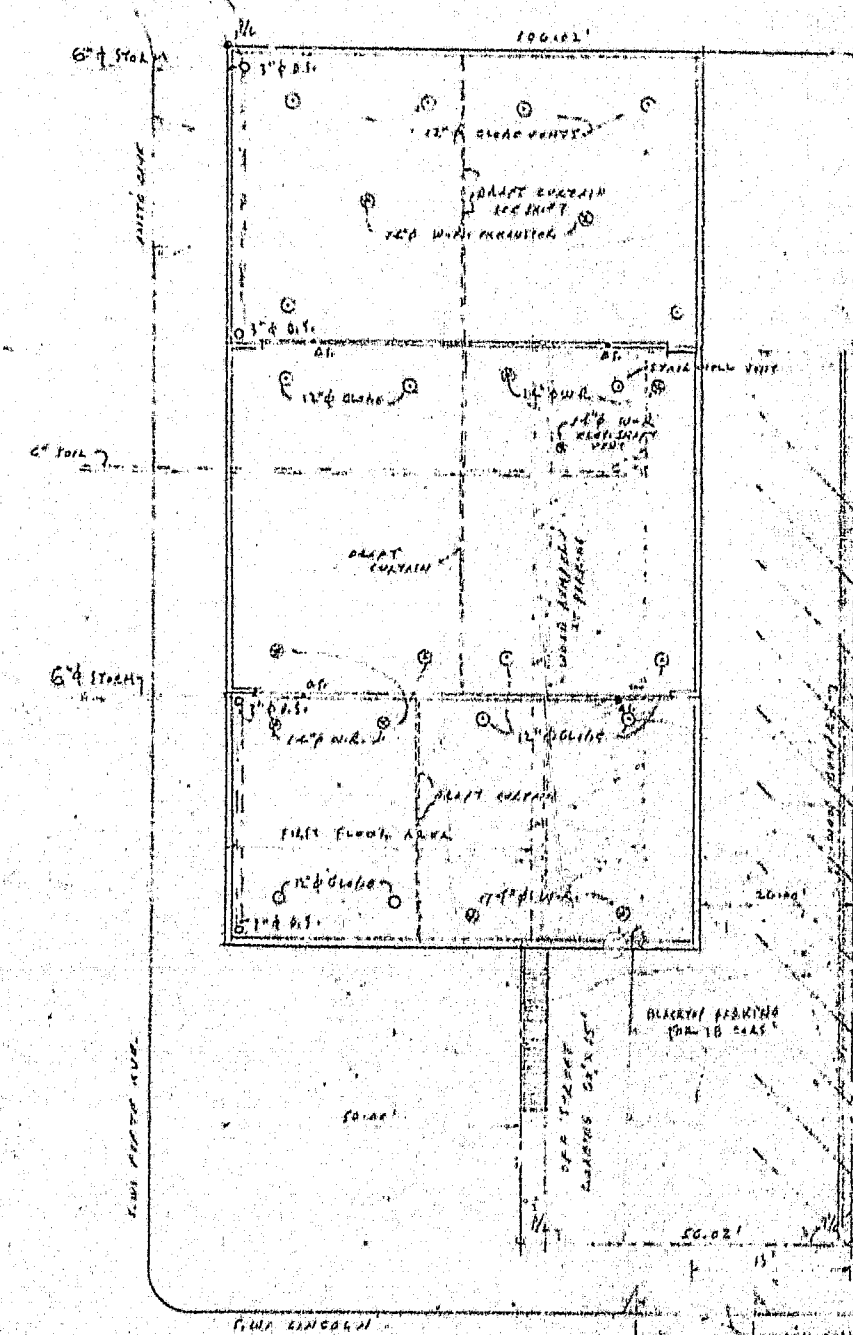


9 10 11 100

MICROFILMED
FEB 2 1979

Poor Quality

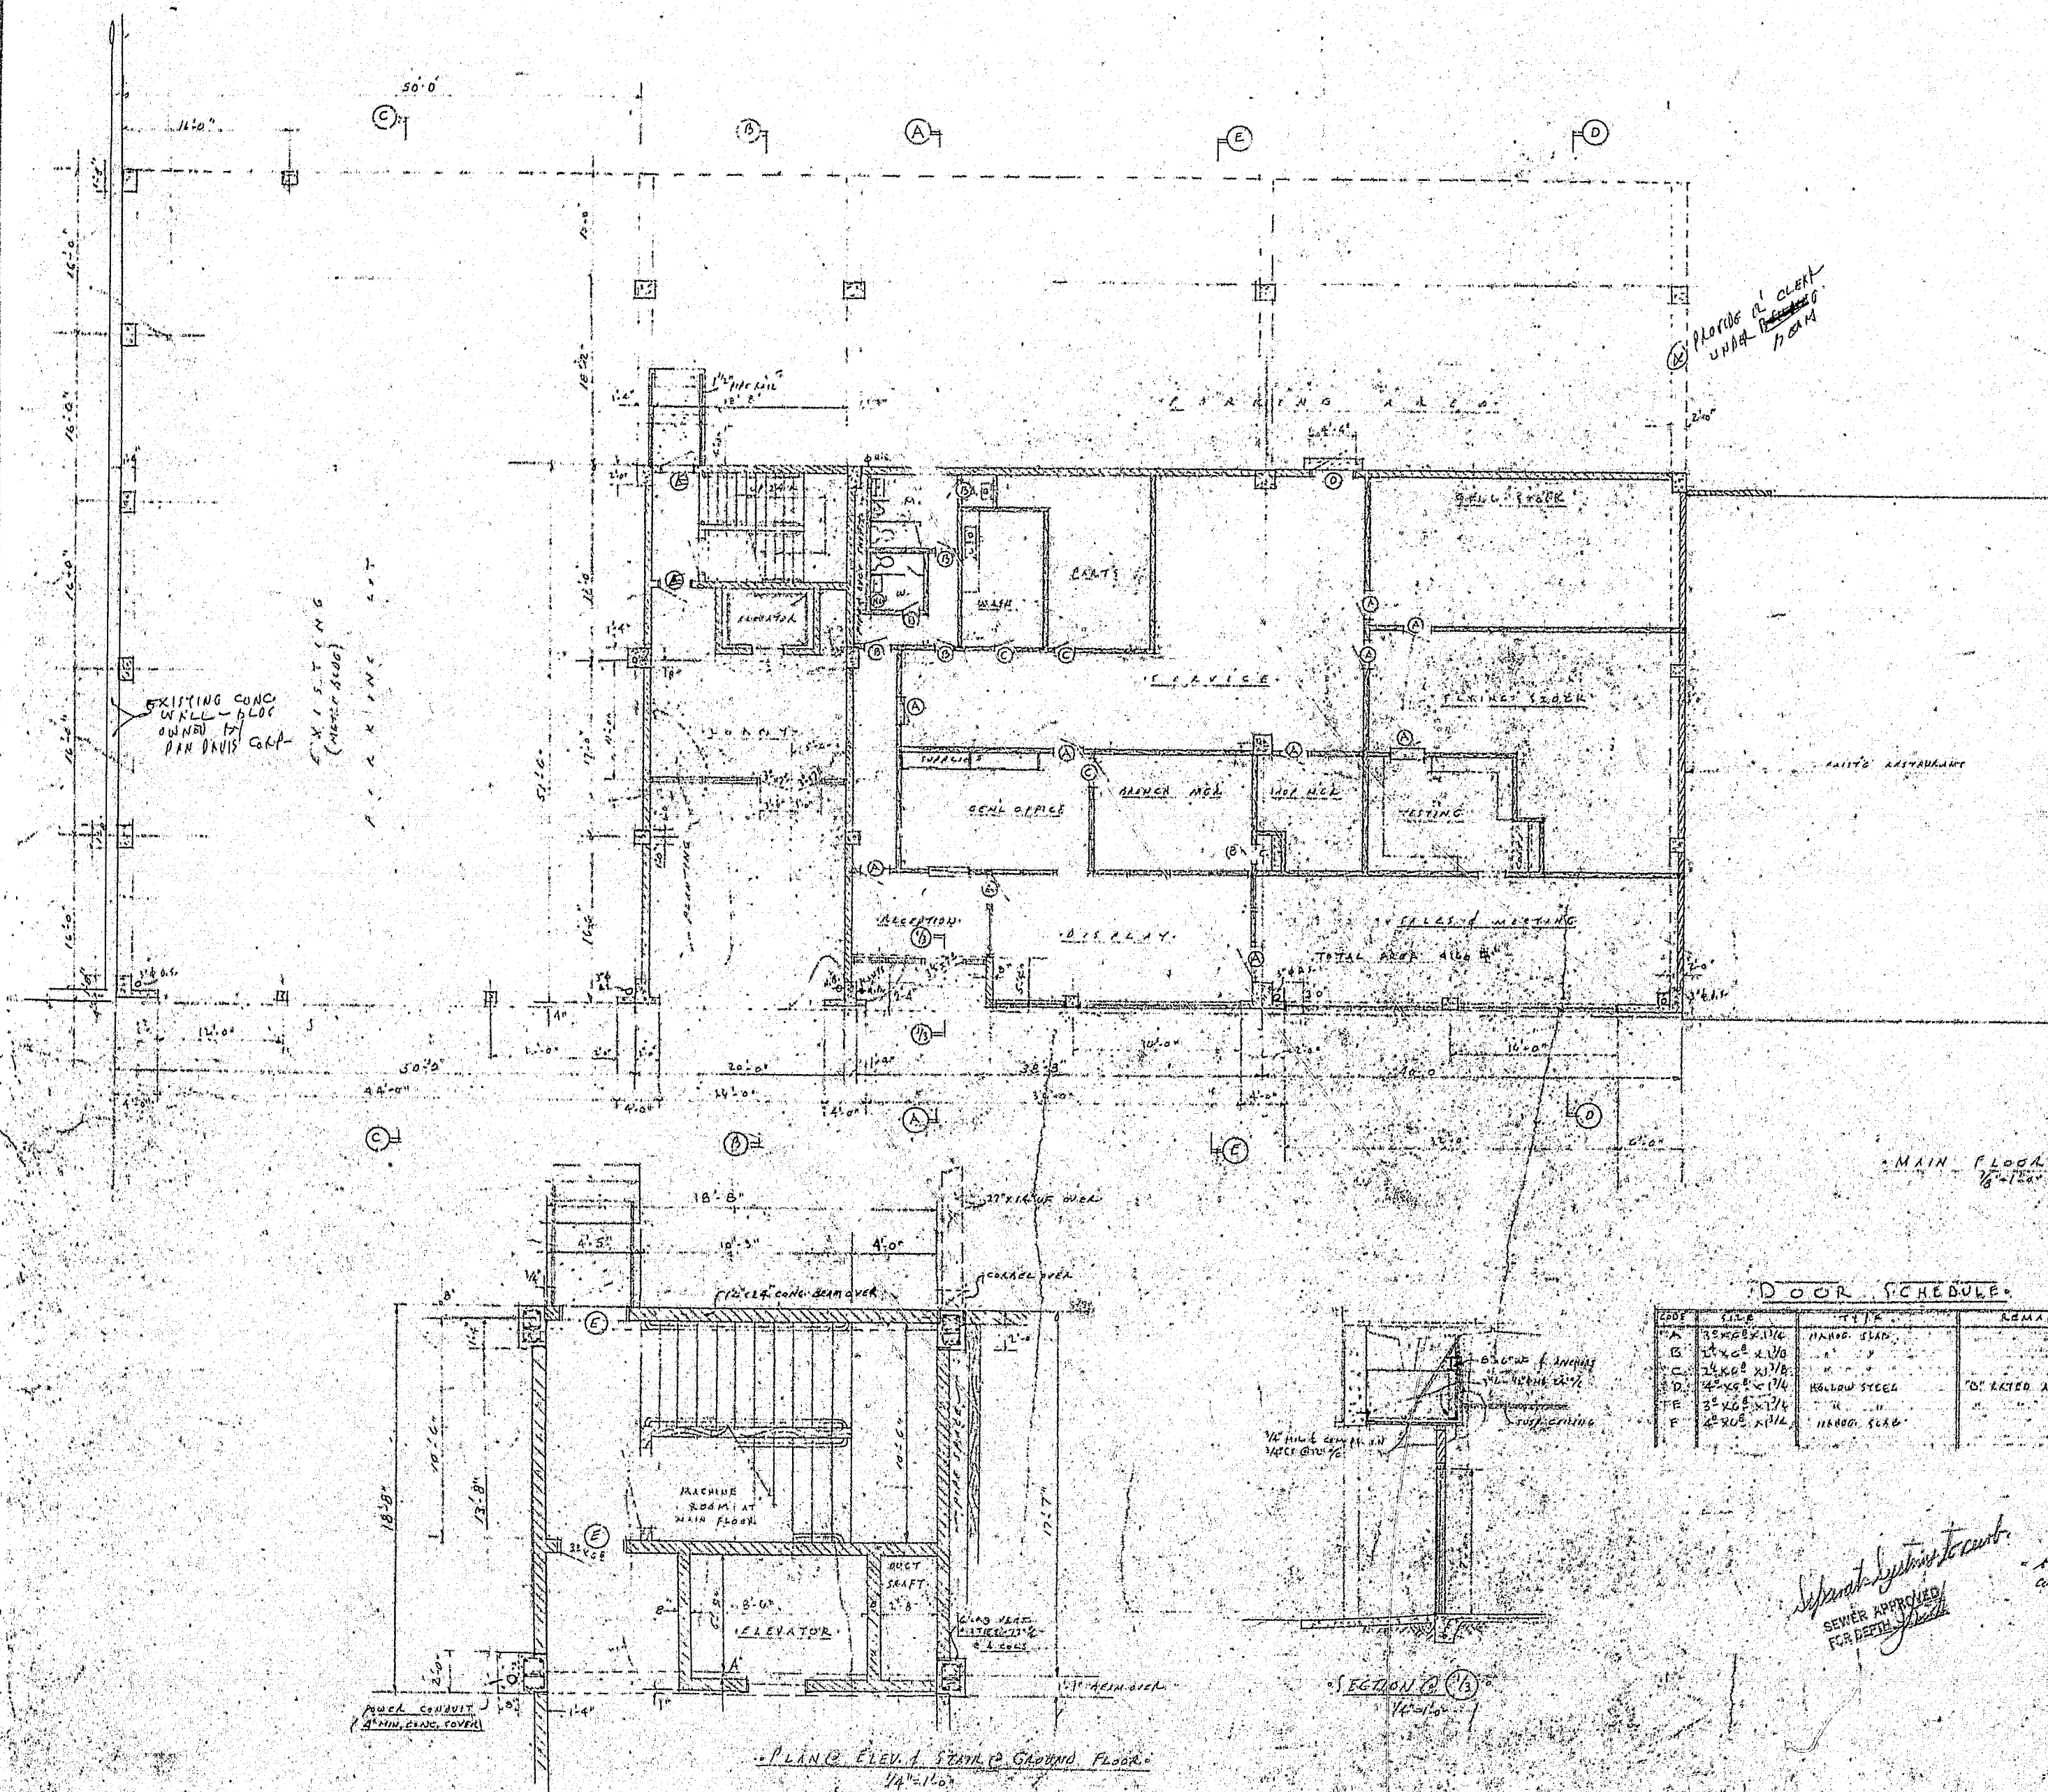

MAIN FLOOR PLAN.
1/8" = 1'-0"
4000

Plot of Roof Plate

E. Side of Lot 5; lots 6, 7 & 8 Block 7
CARPENTHERS' ADD. TO CARR.

ALL CONSTRUCTION TO CONFORM TO REQUIREMENTS
FOR TYPE V-1 HOUR BUILDING.

[illegible]

" ALL TOILET ROOMS TO HAVE 48"
WAINSCOTS OF EPOXY FINISH.

OFFICE BUILDING FOR-

DAN DAVIS CORP.
PORTLAND, OREGON

• • HARRY L. PERCY, JR. A. I. A. • •
ARCHITECT

• SIDNEY P. LATHROP, C.E. •
ENGINEERING CONSULTANT

1973 S. W. FIFTH AVE. PORTLAND 1, ORE.

$P = 3 - 1 = 64$
6403
3