


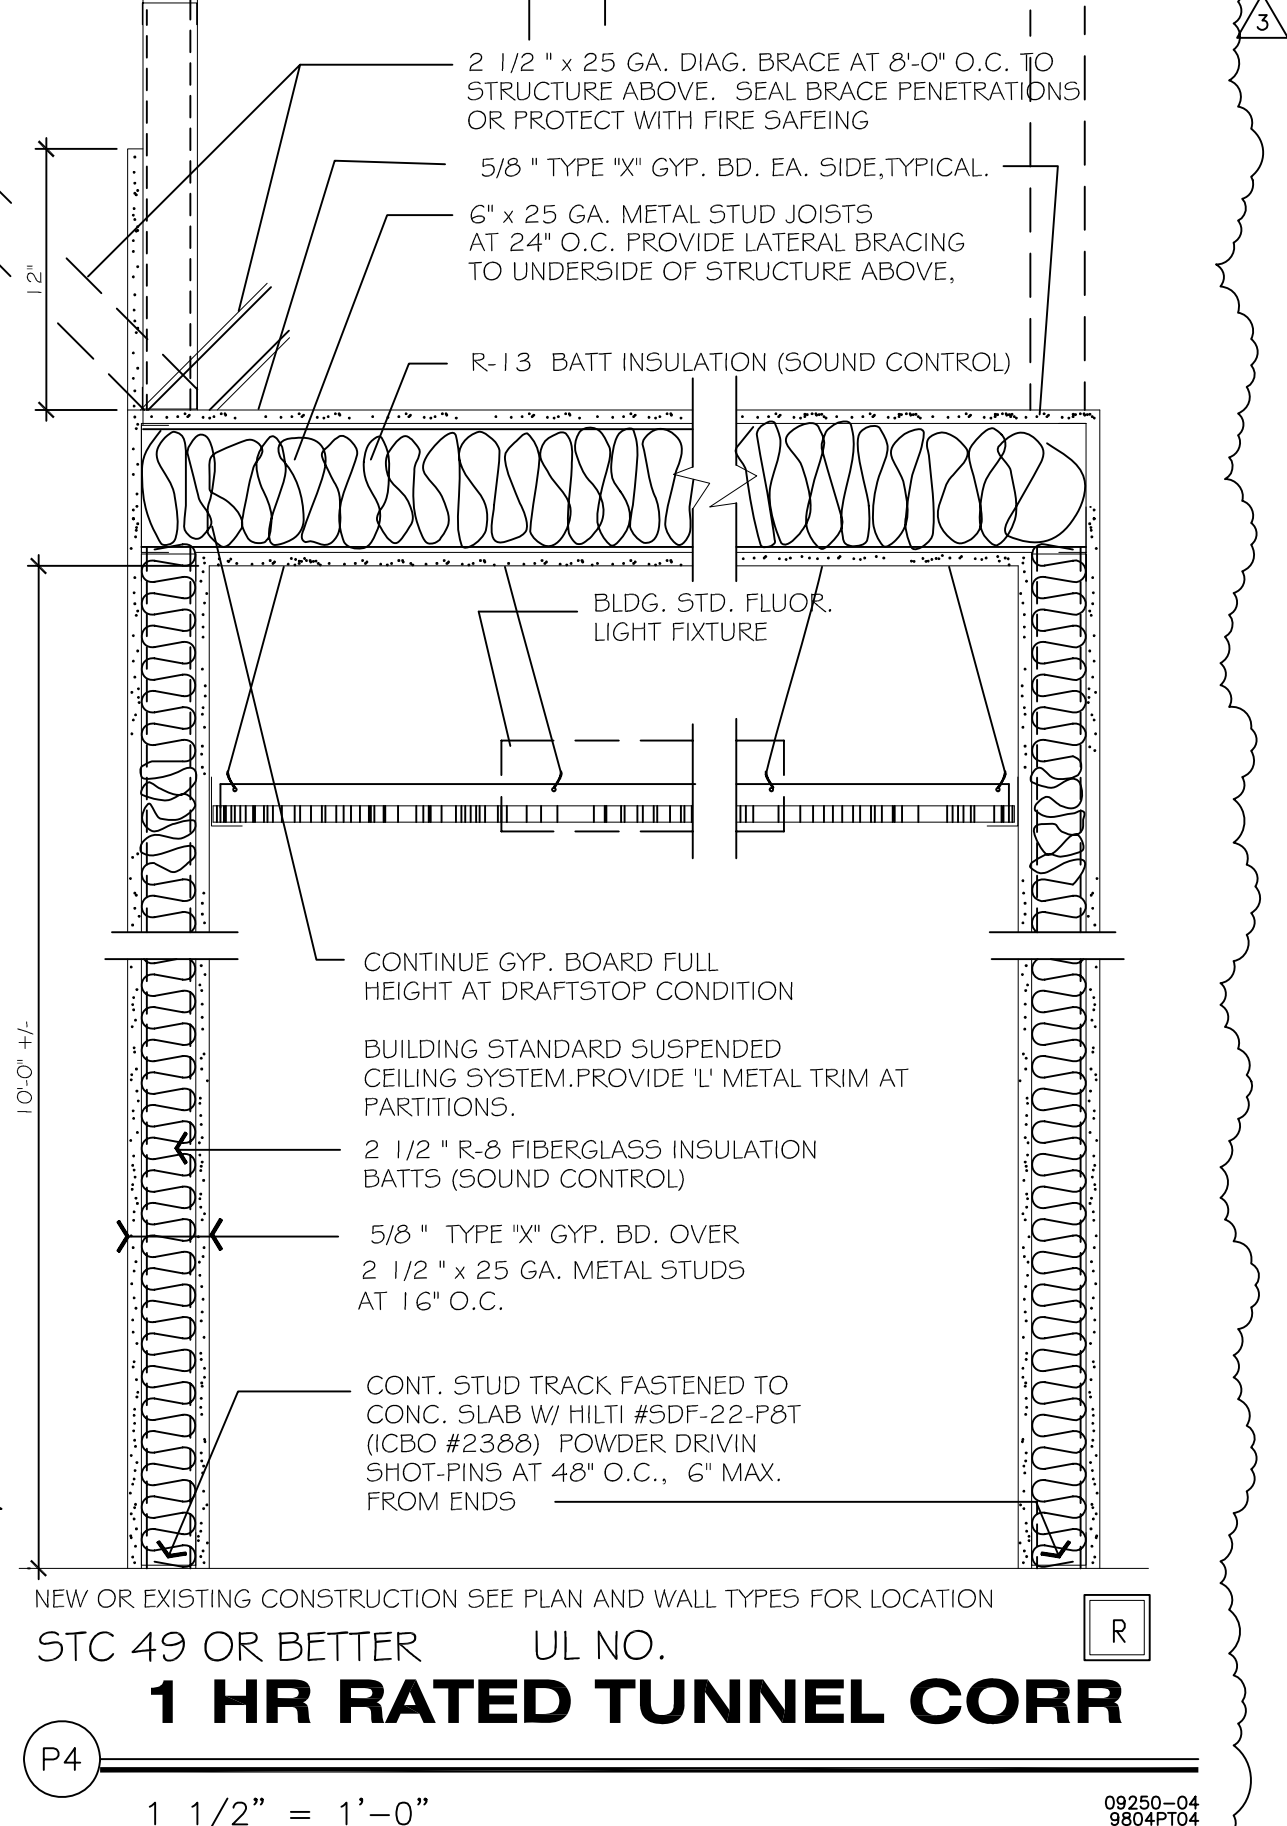

NUMBER	FLOOR	BASE	NORTH WALL	EAST WALL	SOUTH WALL	WEST WALL	CEILING	REMARKS
	CARPET CERAMIC TILE (12X12) EXISTING VCT	CARPET - STITCHED TOP CERAMIC TILE 6X12 EXISTING RUBBER COVE	EXISTING EXISTING PAINT EXISTING / PATCH PAINT GYPSUM WALL BOARD (PAINT)	EXISTING EXISTING PAINT EXISTING / GMB (PAINT) EXISTING / PATCH PAINT GYPSUM WALL BOARD (PAINT)	EXISTING EXISTING PAINT EXISTING / PATCH PAINT GYPSUM WALL BOARD (PAINT)	EXISTING EXISTING PAINT EXISTING / PATCH PAINT GYPSUM WALL BOARD (PAINT)	2X2 ACT. TYPE EXISTING EXISTING / GMB (PAINT) GYPSUM WALL BOARD (PAINT)	
101								
102								
103								
138A								
139								
140								
141								
142								
143								
144								
145								
146								
148								
149								
150								
151								
152								
153								
154								
155								

98-04

RENOVATIONS TO THE
ART INSTITUTES INTL @ PORTLAND
2000 SW FIFTH AVENUE
PORTLAND, OR 97201-4972

RECORD DRAWINGS

EDUCATION MANAGEMENT CORPORATION
300 SIXTH AVENUE
PITTSBURGH, PENNSYLVANIA 15222

A211

3 ENTIRE
SHIFT