


12

FILE NAME: ART INSTITUTE
PLOT DATE: 3/8/99

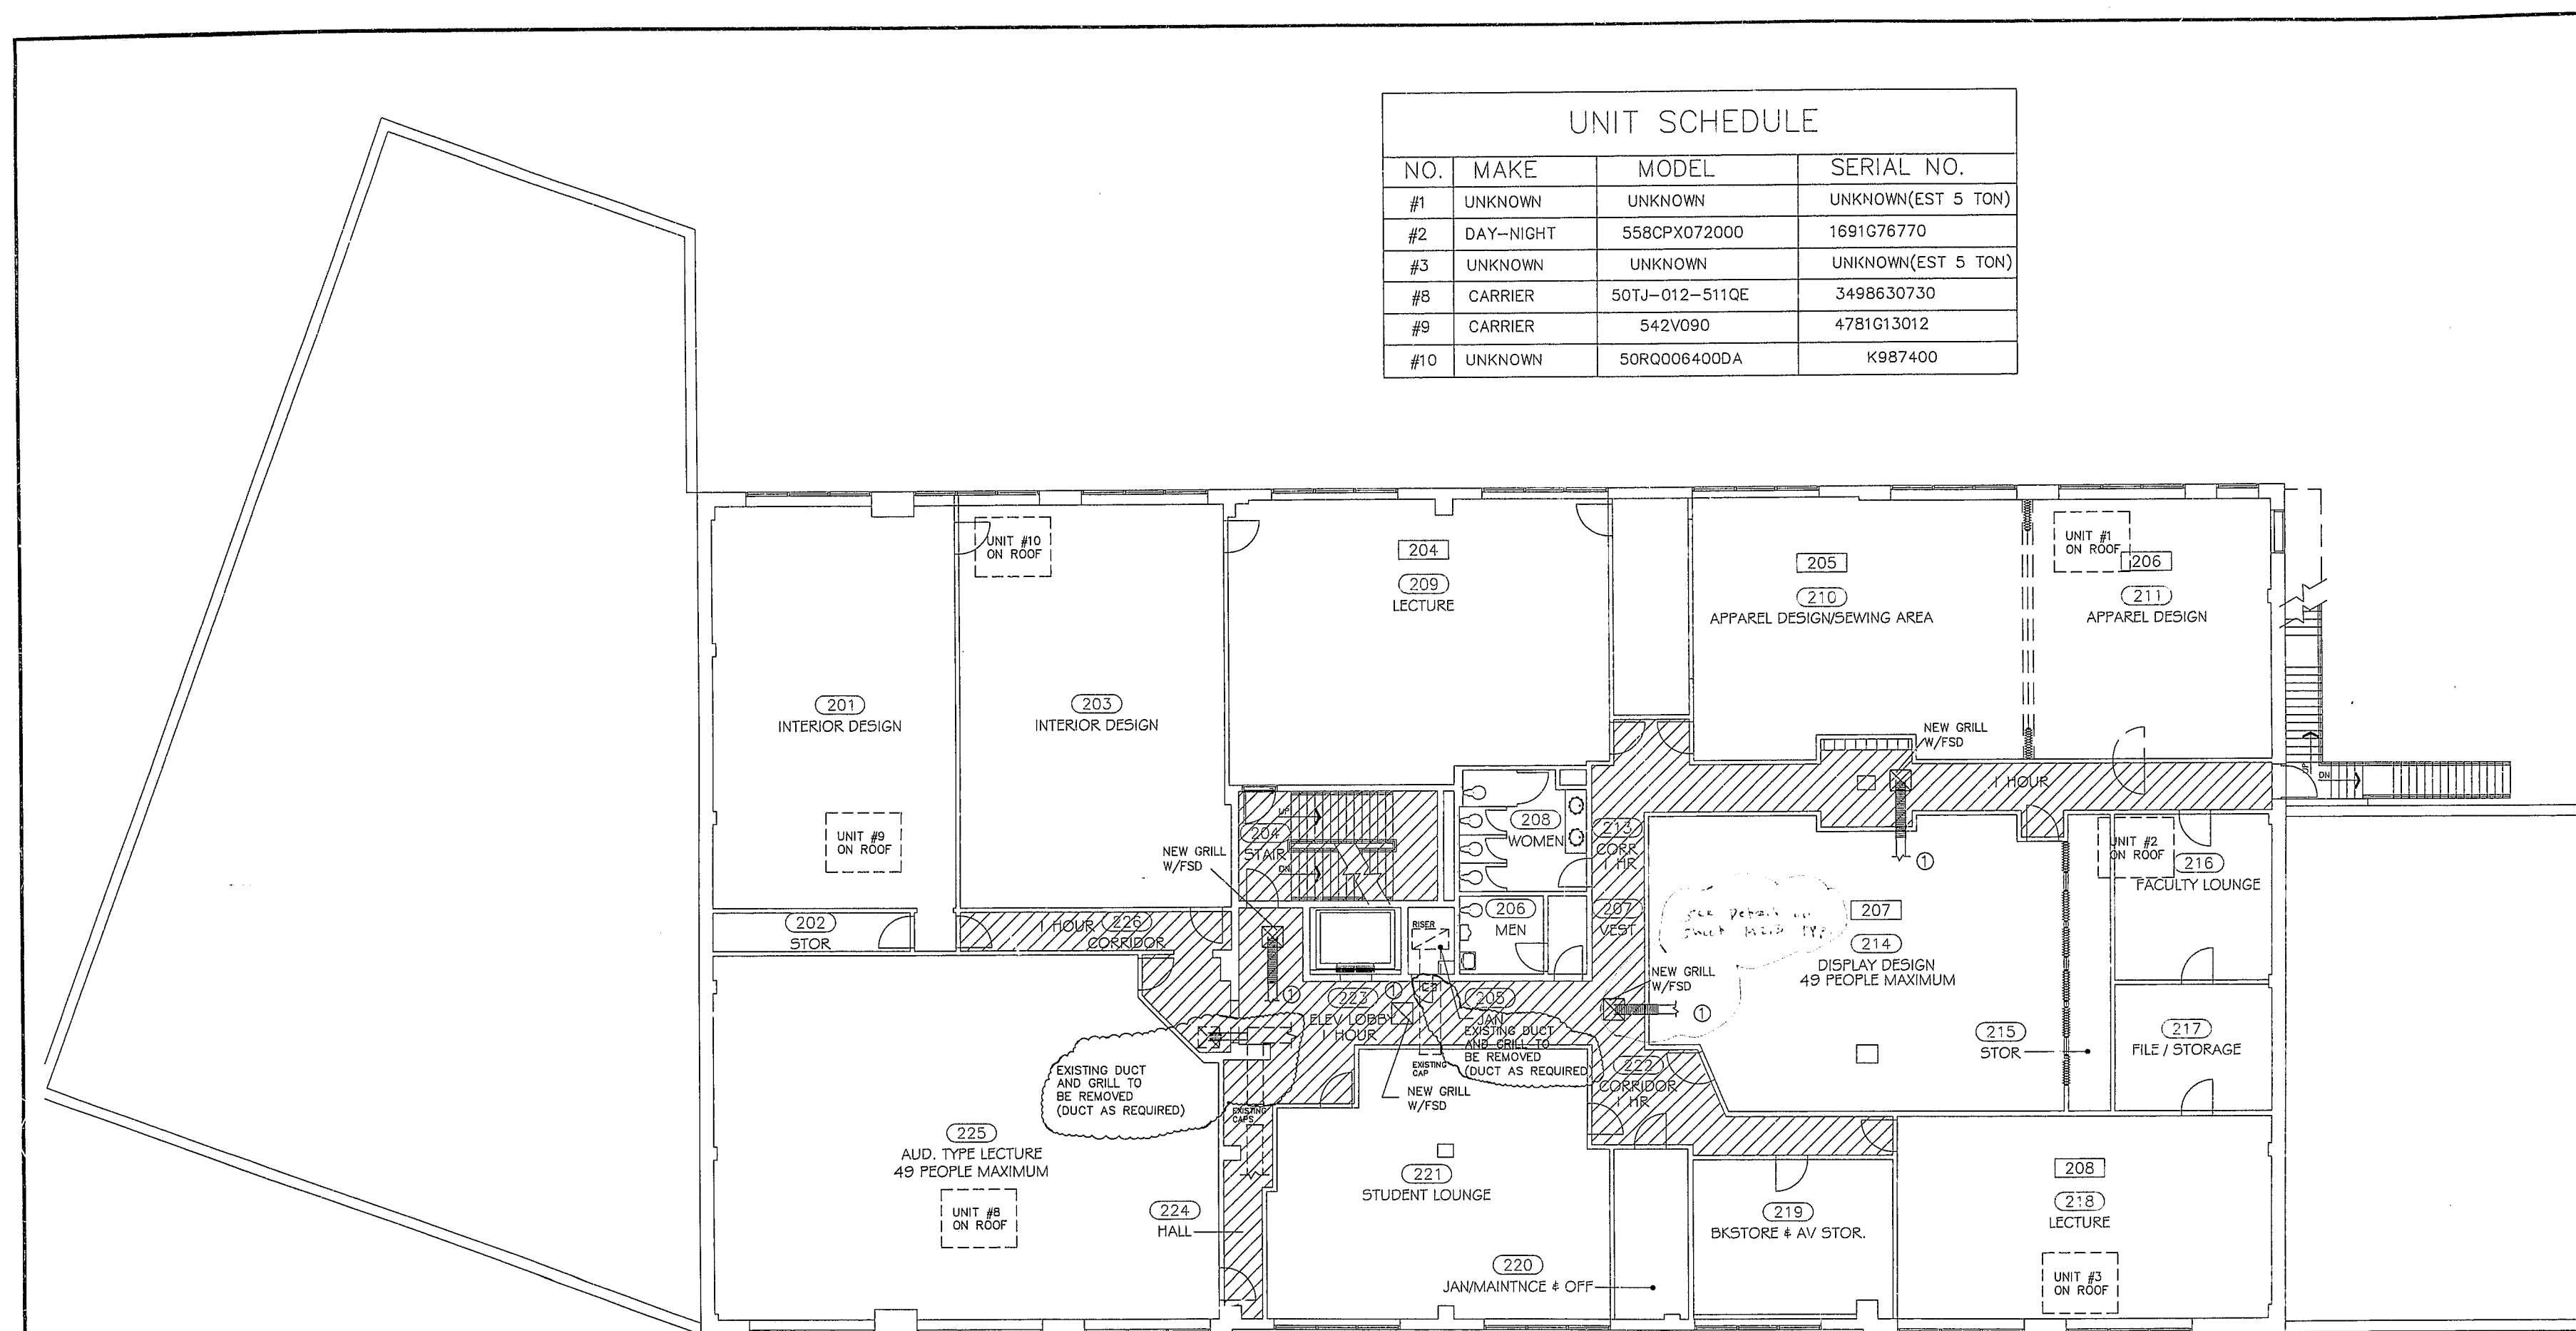

UNIT SCHEDULE			
NO.	MAKE	MODEL	SERIAL NO.
#1	UNKNOWN	UNKNOWN	UNKNOWN(EST 5 TON)
#2	DAY-NIGHT	558CPX072000	1691G76770
#3	UNKNOWN	UNKNOWN	UNKNOWN(EST 5 TON)
#8	CARRIER	50TJ-012-511QE	3498630730
#9	CARRIER	542V090	4781G13012
#10	UNKNOWN	50RQ006400DA	K987400

KEYED NOTES

- DUCT FROM NEW GRILL W/FSD TO BE ROUTED TO EXISTING DUCT SYSTEM.
- EXISTING DUCT IS DUCTBOARD. MUST BE REPLACED IN RATED CEILING AREA.

GENERAL NOTES

- ALL EXISTING DUCT AND EQUIPMENT LOCATIONS SHOWN ARE APPROXIMATE LOCATIONS. TCM WAS NOT SUPPLIED AS BUILT DRAWINGS.

SECOND FLOOR HVAC

1/8" = 1'-0"



HVAC 2ND FLOOR
ART INSTITUTES INTL
PORTLAND
2000 SW 5TH

Job No. 5098

M2.1

TCM Temp-Control Mechanical Corp
4500 N CHANNEL AVENUE PO BOX 11065
PORTLAND, OR 97211 (503) 285-9851
"Proud Of Our Work!"

Rev. No.	Date	Drawn by	Description
	3/8/99	BARKER	