A

1 DOOR TYPES

1/4" = 1'-0"

DOORTYPE
9804DTYP

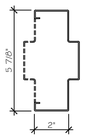

1

2 FRAME PROFILES

3" = 1'-0"

FRAMEPRO
9804FPRO

DOOR REMARKS

(A) CYLINDER LOCK REPLACED ONLY
(B) CYLINDER LOCK BY HARDWARE SUPPLIER, HARDWARE BY DOOR MANUFACTURER.
(C) DOOR CLOSER
(D) DOOR HOLDER
(E) EXIT ALARM
(F) FIRE EXIT HARDWARE
(G1) 1/4" CLEAR TEMPERED PLATE GLASS
(G2) 1/4" POLISHED PLATE CLEAR WIRE GLASS SQUARE PATTERN
(G3) 1" INSULATED TINTED TEMPERED GLASS
(G4) 1" INSULATED CLEAR TEMPERED GLASS
(G5) 1" INSULATED SPANDREL GLASS
(G6) 1/2" LAMINATED SPANDREL GLASS
(G7) 1/2" LAMINATED SAFETY GLASS
(H) CONTINUOUS HINGE
(I) INSTALL NEW DOOR & FRAME IN EXISTING OPENING (FIELD MEASURE)
(J) KICKPLATE
(K) KNURLED HARDWARE FOR HAZARD WARNING
(L) LIGHT PROOF DOOR SEAL
(M) MATCH EXISTING DOOR AND DOOR FRAME MATERIAL / FINISH, HEIGHT, HARDWARE STYLE AND FUNCTIONS OF SIMILAR DOORS IN THAT LOCATION (FIELD VERIFY)
(N) SOUNDPROOF DOOR SEAL
(O) SMOKE / FIRE ALARM ACTIVATED HOLD OPEN
(P) PANIC HARDWARE
(Q) NOT USED
(R) REMOVABLE CENTER MULLION
(S) SMOKE AND DRAFT CONTROL SEAL
(T) THRESHOLD
(U) UNDERCUT 1"
(V) COORDINATE HINGE AND STRIKE LOCATION ON NEW DOOR(S) WITH EXISTING FRAME TO REMAIN. FIELD MEASURE NEW DOOR DIMENSIONS.
(W) NOT USED
(X) EXISTING
(Y) NOT USED
(Z) DOOR TO BE LOCKABLE FROM NON PANIC SIDE

3 DOOR REMARKS

1'-0" = 1'-0"

DOORREMK
9804DREM

NOTE: IN LIEU OF G2 GLAZING PROVIDE UNRATED SAFETY GLASS WITH SPRINKLER RANGE ADEQUATE TO WET ALL SURFACES.

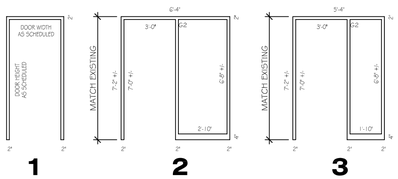

G1 = 1/4" CLEAR TEMPERED PLATE GLASS
G2 = 1/4" POLISHED PLATE CLEAR WIRE GLASS
G3 = 1" INSULATED TINTED TEMPERED GLASS
G4 = 1" INSULATED CLEAR TEMPERED GLASS
G5 = 1" INSULATED SPANDREL GLASS
G6 = 1/2" LAMINATED SPANDREL GLASS
G7 = 1/2" LAMINATED SAFETY GLASS

4 FRAME TYPES

1/4" = 1'-0"

FRAMETYP
9804FTYP

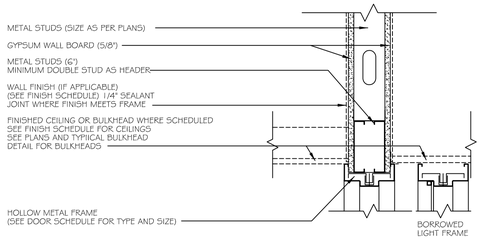

SEE PLAN FOR DOOR LOCATION

H1 HOLLOW METAL HEAD DETAIL

1 1/2" = 1'-0"

08100-01
9804DT05

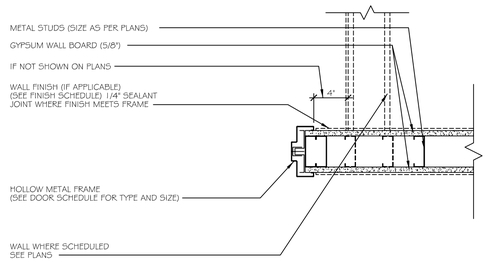

SEE PLAN FOR DOOR LOCATION

J1 HOLLOW METAL JAMB DETAIL

1 1/2" = 1'-0"

08100-11
9804DT06

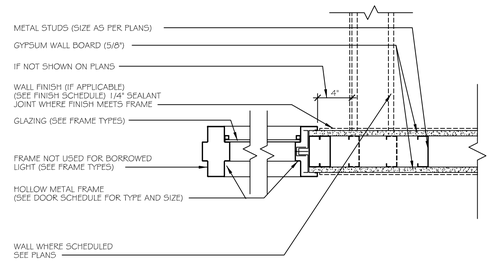

SEE PLAN FOR DOOR LOCATION

J2 HOLLOW METAL JAMB DETAIL

1 1/2" = 1'-0"

08100-12
9804DT07

SEE PLAN FOR DOOR LOCATION

J3 HOLLOW METAL JAMB DETAIL

1 1/2" = 1'-0"

08100-13
9804DT08

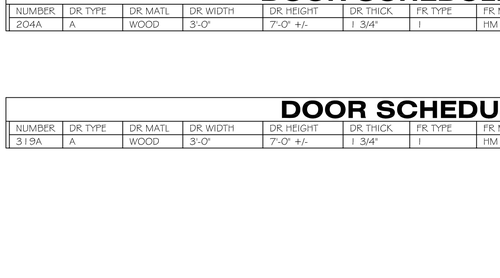

SEE PLAN FOR DOOR LOCATION

J4 HOLLOW METAL JAMB DETAIL

1 1/2" = 1'-0"

08100-16
9804DT09

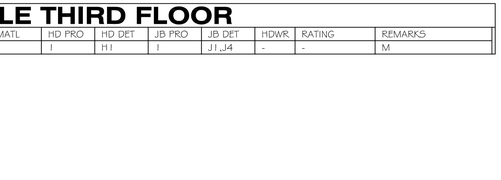

S1 HOLLOW METAL SILL DETAIL

1 1/2" = 1'-0"

08100-32
9804DT10

DOOR SCHEDULE FIRST FLOOR

NUMBER	DR TYPE	DR MATL	DR WIDTH	DR HEIGHT	DR THICK	FR TYPE	FR MATL	HD PRO	HD DET	JB PRO	JB DET	HDWR	RATING	REMARKS
121A	A	WOOD	3'-0"	7'-0" +/-	1 3/4"	1	HM	1	H1	1	J1,J3	-	20 MIN.	C,M,S
122A	A	WOOD	3'-0"	7'-0" +/-	1 3/4"	1	HM	1	H1	1	J1,J3	-	20 MIN.	C,M,S
123A	A	WOOD	3'-0"	7'-0" +/-	1 3/4"	1	HM	1	H1	1	J1,J3	-	-	M
125A	A	WOOD	3'-0"	7'-0" +/-	1 3/4"	1	HM	1	H1	1	J1	-	20 MIN.	C,M,S
127A	A	WOOD	3'-0"	7'-0" +/-	1 3/4"	1	HM	1	H1	1	J1	-	20 MIN.	C,M,S
138A	A	WOOD	3'-0"	7'-0" +/-	1 3/4"	1	HM	1	H1	1	J1,J3	-	20 MIN.	C,M,S
140A	A	WOOD	3'-0"	7'-0" +/-	1 3/4"	1	HM	1	H1	1	J1,J4	-	-	M
141A	A	WOOD	3'-0"	7'-0" +/-	1 3/4"	1	HM	1	H1	1	J1,J3	-	-	M
142A	A	WOOD	3'-0"	7'-0" +/-	1 3/4"	3	HM	1	H1	1	J1,J2	-	20 MIN.	C,M,S
143A	A	WOOD	3'-0"	7'-0" +/-	1 3/4"	1	HM	1	H1	1	J1,J3	-	-	M
144A	A	WOOD	3'-0"	7'-0" +/-	1 3/4"	1	HM	1	H1	1	J1,J3	-	-	M
145A	A	WOOD	3'-0"	7'-0" +/-	1 3/4"	1	HM	1	H1	1	J1,J3	-	-	M
146A	A	WOOD	3'-0"	7'-0" +/-	1 3/4"	1	HM	1	H1	1	J1,J3	-	20 MIN.	C,M,S
149A	A	WOOD	3'-0"	7'-0" +/-	1 3/4"	1	HM	1	H1	1	J1,J3	-	-	M
150A	A	WOOD	3'-0"	7'-0" +/-	1 3/4"	1	HM	1	H1	1	J1,J3	-	-	M
151A	A	WOOD	3'-0"	7'-0" +/-	1 3/4"	1	HM	1	H1	1	J1,J3	-	-	M
152A	A	WOOD	3'-0"	7'-0" +/-	1 3/4"	1	HM	1	H1	1	J1,J3	-	-	M

DOOR SCHEDULE SECOND FLOOR

NUMBER	DR TYPE	DR MATL	DR WIDTH	DR HEIGHT	DR THICK	FR TYPE	FR MATL	HD PRO	HD DET	JB PRO	JB DET	HDWR	RATING	REMARKS
204A	A	WOOD	3'-0"	7'-0" +/-	1 3/4"	1	HM	1	H1	1	J1,J3	-	1 HOUR	C,F,M,S

DOOR SCHEDULE THIRD FLOOR

NUMBER	DR TYPE	DR MATL	DR WIDTH	DR HEIGHT	DR THICK	FR TYPE	FR MATL	HD PRO	HD DET	JB PRO	JB DET	HDWR	RATING	REMARKS
319A	A	WOOD	3'-0"	7'-0" +/-	1 3/4"	1	HM	1	H1	1	J1,J4	-	-	M

DWG NAME: 9804231.DWG
DWG SCALE: 1'-0" = 1'-0"
DWG DATE: 10/25/1999

ISSUE DATE:
12 JUN 1998

PLOT DATE:	25 FEB 1999
REV NO:	REVISION DATE:
1	08 JAN 1999
3	24 FEB 1999

PROJECT NUMBER:
98-04

RENOVATIONS TO THE
ART INSTITUTES INTL @ PORTLAND
RECORD DRAWINGS
2000 SW FIFTH AVENUE
PORTLAND, OR 97201-4972
EDUCATION MANAGEMENT CORPORATION
300 SIXTH AVENUE
PITTSBURGH, PENNSYLVANIA 15222

EDUCATION
MANAGEMENT
CORPORATION

FACILITIES
DIVISION

219 NORTH MAIN STREET
PITTSBURGH, PA. 15215-2020
PHONE NO. (412) 562-0900
FAX NO. (412) 781-6571

DOOR SCHEDULE / DETAILS

DRAWING NUMBER: 3 ENTIRE SHEET
A221